

N3E3


PARKWAY
SUPER
MARKET

PFaff STREET



ROOSEVELT

9-1

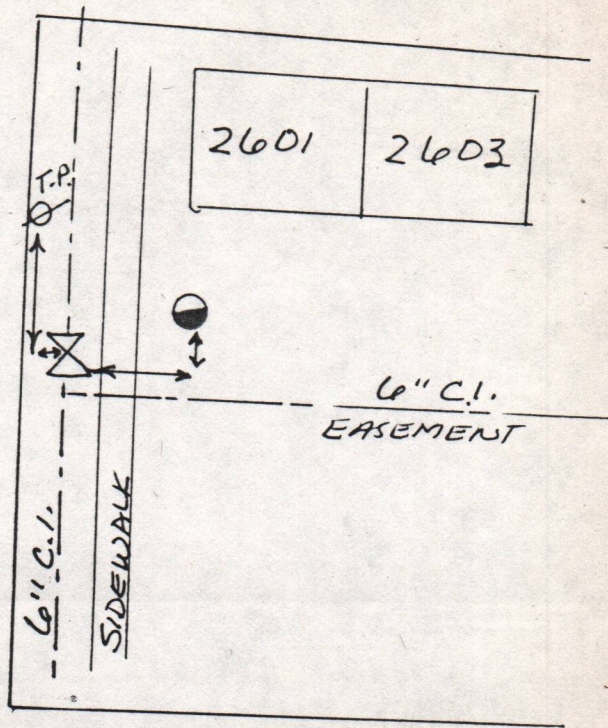

KNOX