

N3E3


PARKWAY  
SUPER  
MARKET



PFaff  
STREET

ROOSEVELT

9-2

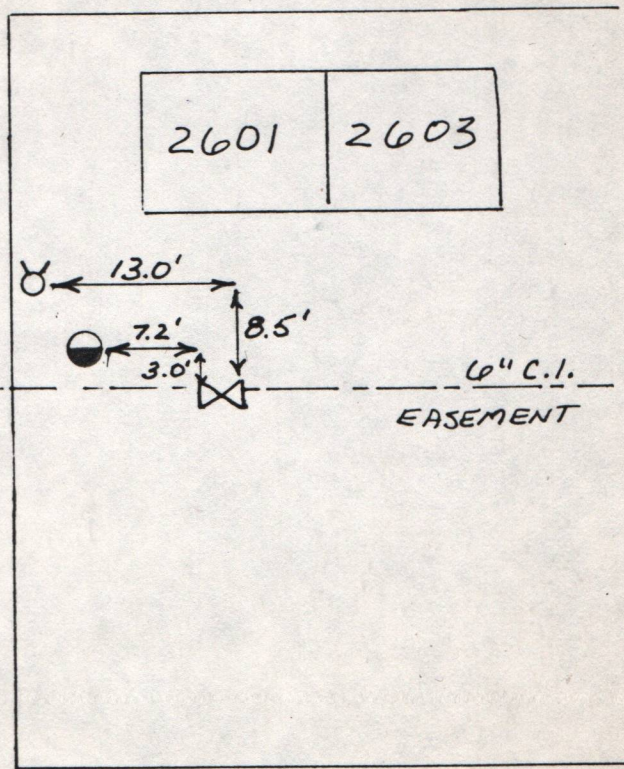

KNOX AVENUE