

13-1

II




WASHINGTON
AVE.

42.0

ABNEY ST.

N 3 W 1


511

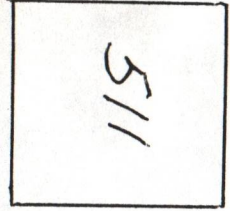

$\frac{69}{47}$

10.6

Φ

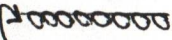

WALL


22.0

1" CI

18"



X X X X X

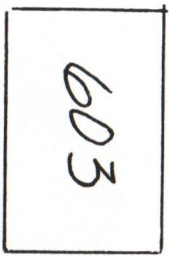

603

X X X X X
FENCE