



N3W1

13-
13-5

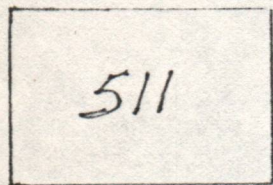

511

6" C.I.

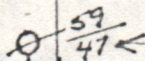

59
47

11.4'

WASH. AVE.




17.0'

VALVE BROKE
13.6
backs it up

40.0'

X X X X

FENCE

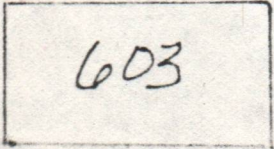

603

X
X
X
X

ABNEY