


N3W1

14-1

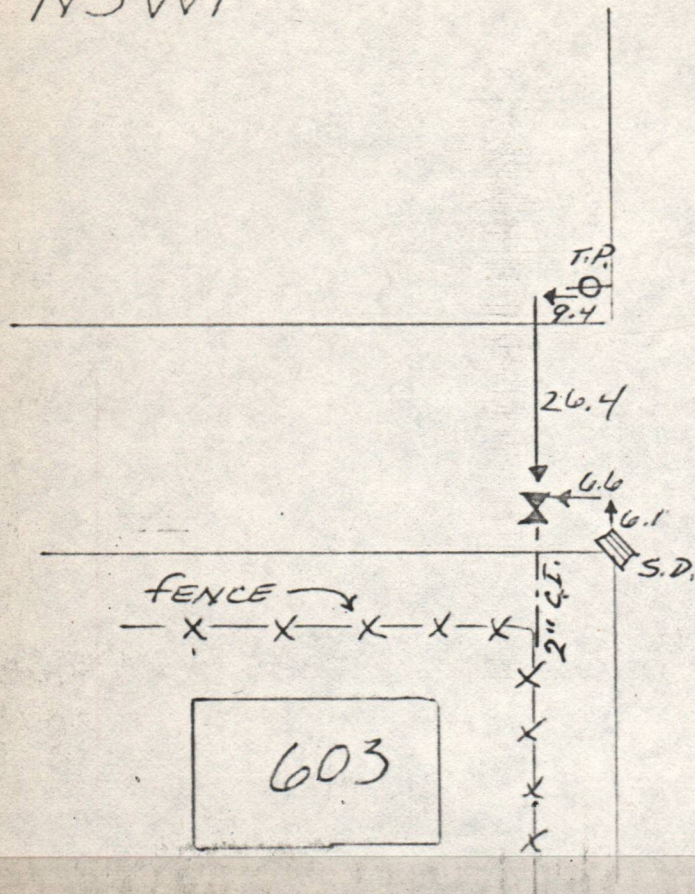

HANSFORD ST. 1

WASHINGTON AVE.