


N3W1

14-3

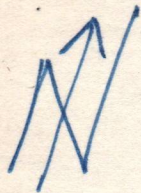

Alley

2" c.l.

From TP
NORTH 1'
WEST 1'

137B1009

8" c.l.

8" c.l.

WASHINGTON

AVE

TO
HANSFORD

GRAVEL

TO
CUNNINGHAM