


15-6

NOT
PREVIOUSLY
MAPPED
5-19-86

N3W1

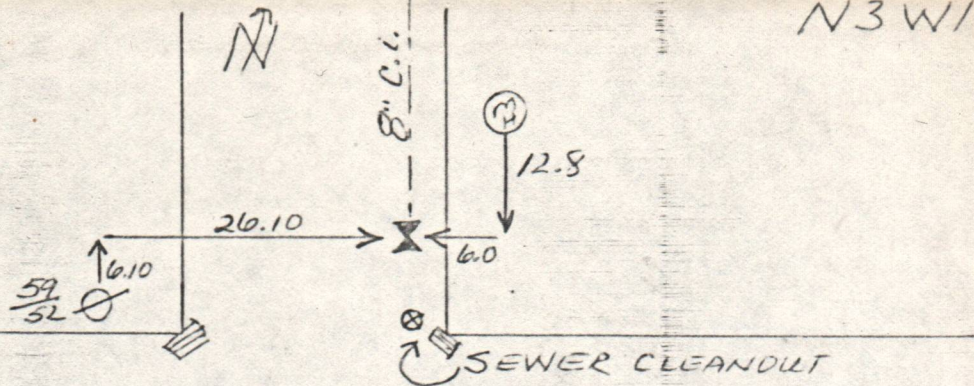

WASHINGTON

AVENUE

CUNNINGHAM