


17-1

N3W1

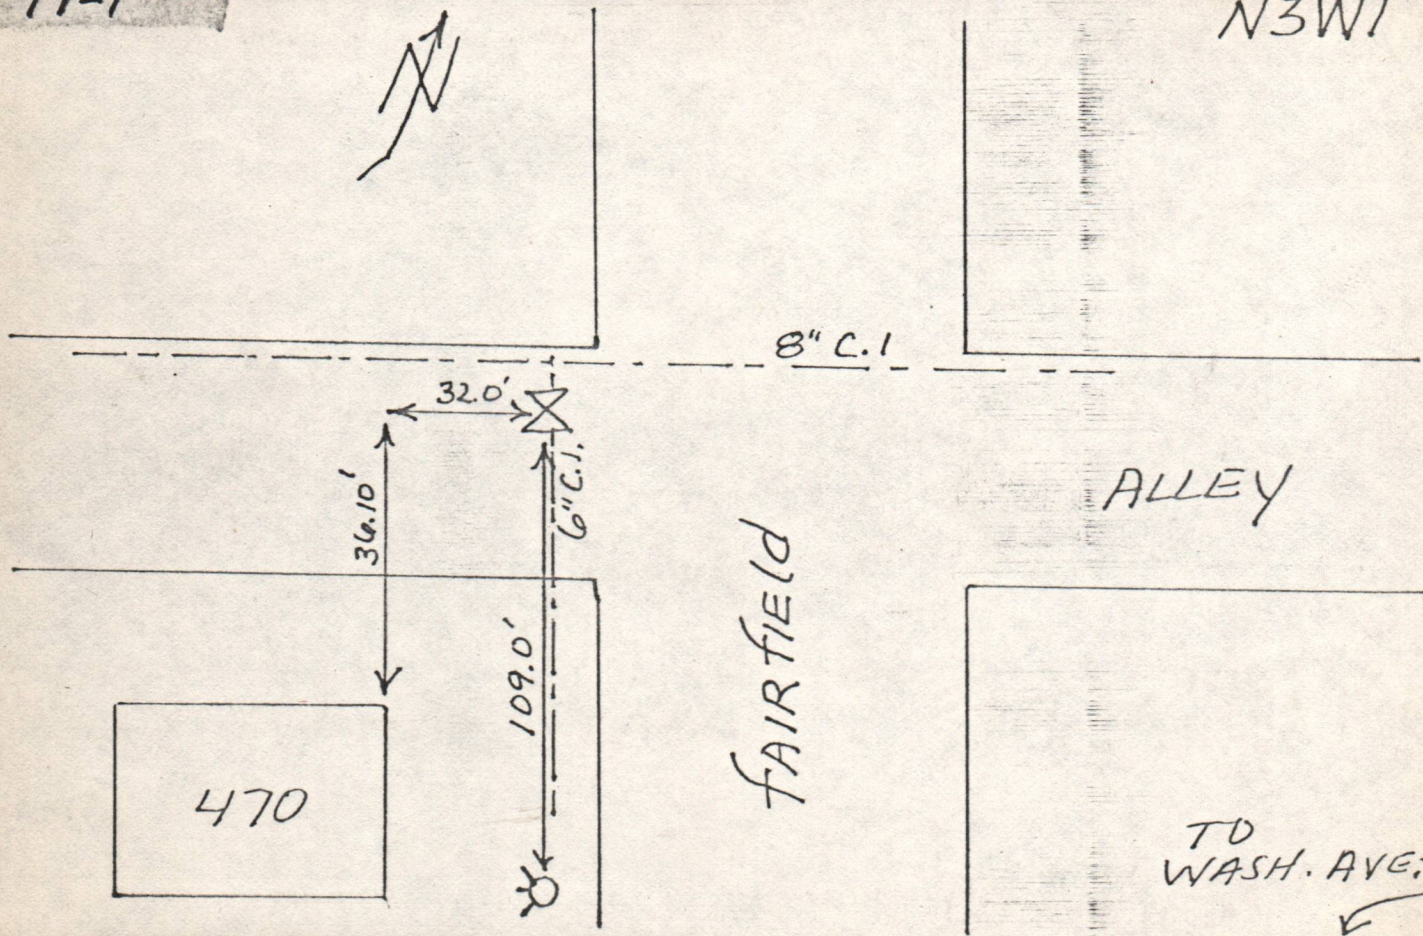

FAIRFIELD