


18-1

N3W1


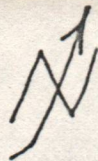


STREET

8" C.I.

ALLEY

FAIRFIELD

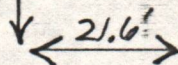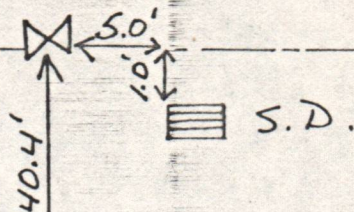

2004
WASH.
AVE.