

19-1


CHURCH

N

ABNEY ST.

N3W1

7TH AVENUE

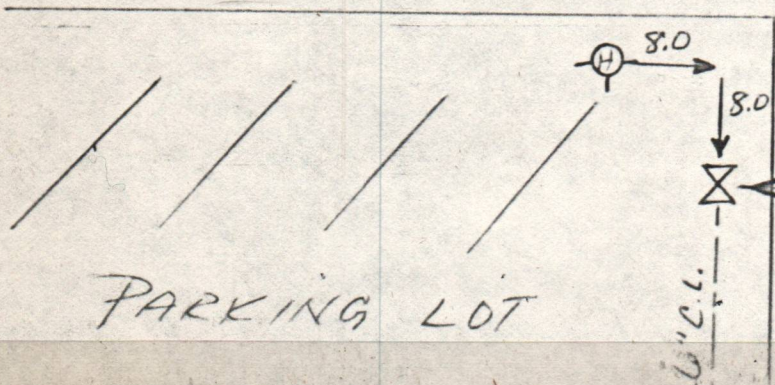

PARKING LOT

C.C.L.

137B304