
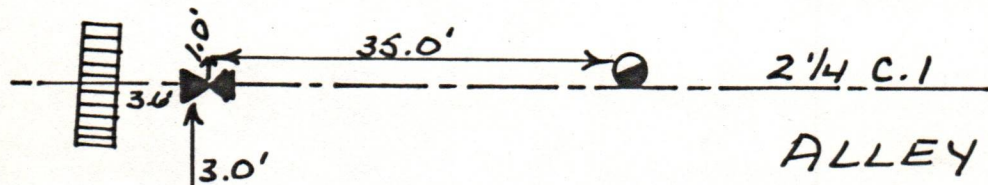


N3W1

6-1

TO
MCKINLEY

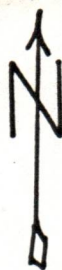

$\frac{2}{8}$ 0 ← 10.0'

FAIRFIELD

TO
ADAMS
AVE. ↘