



N3W1


9-1

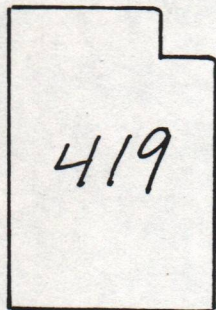

TO
LINCOLN

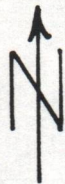

CUNNINGHAM

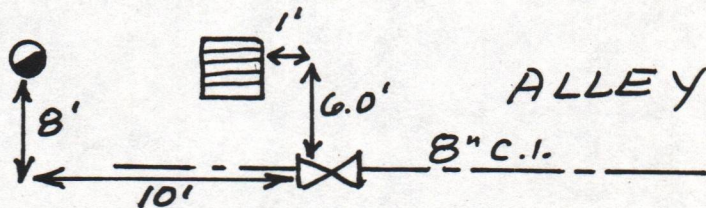

TO
WASH. AVE