


N3W1

9-2

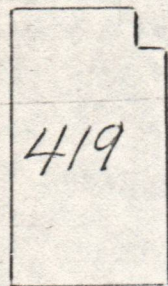

78 - 7.5

29.10

14.5
2" C.I. *

CUNNINGHAM

↑
TO
LINCOLN

ALLEY

TO
WASHINGTON
↓

* NOT MAPPED
5-19-86