

N3W2

11-1


WASHINGTON STREET

6" C.I.



45.0

33.0

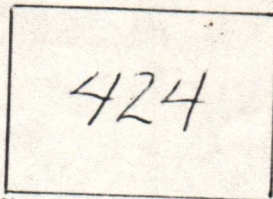

7.5

LINCOLN AVE.

7.5

$\frac{77}{14}$

HANSFORD  
CENTER