

11-2


N3W2



st.

WASHINGTON

39.9'

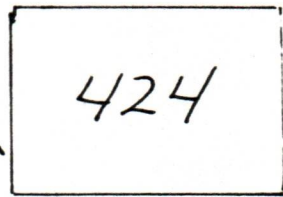

424

34.0'

33.4'

LINCOLN



11.4'

HANSFORD
CENTER