


16-1

N

N3W2

STREET

HANSFORD
CENTER

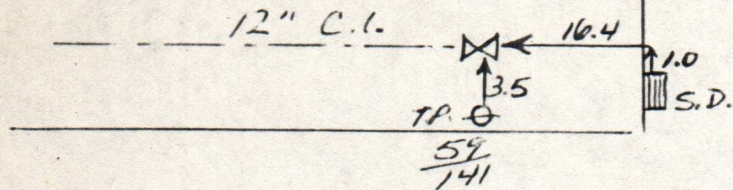

WASHINGTON

AVENUE

CHURCH

WASHINGTON