


N3W2

17-1

STREET

HANSFORD
CENTER

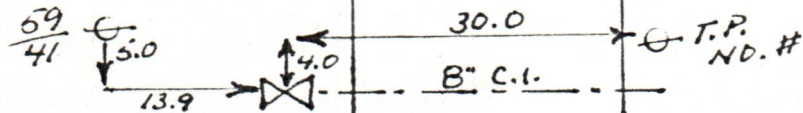

WASHINGTON

AVENUE

CHURCH

WASHINGTON