


19-2

N

N3W2

HANSFORD
CENTER

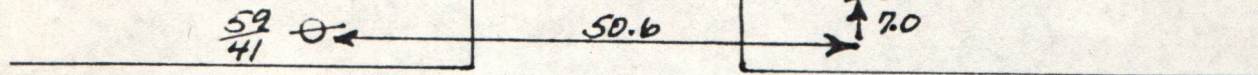

WASHINGTON

AVENUE

CHURCH

WASH. ST.