
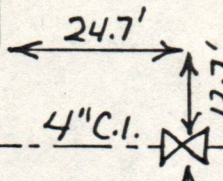


N3W2

24-1

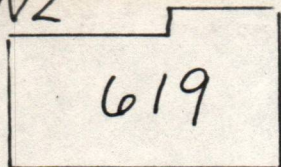

SPRING ST.

2 1/4" C.I.

7th AVE.

41.7'

36.0'

Ø T.P.

