


7-1

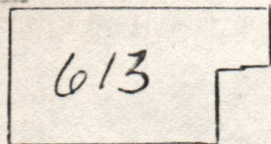

9.0

19.0

2" GAL

28.0

2.0

59
34

N

ST.

HOLLEY

N3W2

7TH AVENUE