


10-22

N

N3W3

10TH ST.

7TH AVENUE

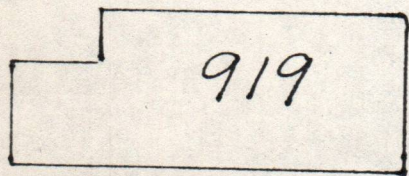

17.0

44.0

13.0

S.D.

4" C.I.

919