


N3W3

12-1

N

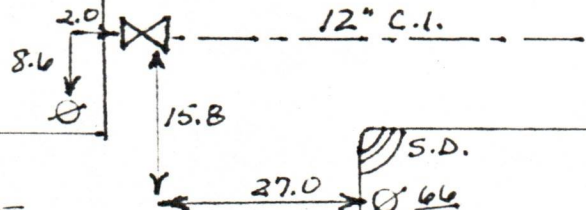

7TH AVE.

SEVENTH AVE.

PARK ST.

1703 APTS.