

12-2


N

N3W3

FENCE



DRIVEWAY

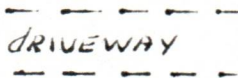

T.P. $\odot$

5.7

12.4

8" C.L.

23.6

20.0

$\odot \frac{66}{11}$

SEVENTH AVE.

SEVENTH AVE

PARK ST.

1703 APTS.

