


N3W3

12-3

2" c.l.

St.

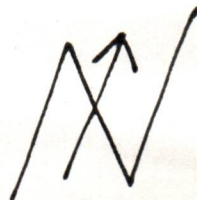

Lincoln

AVE

2" c.l.



37'

Spring

137868

10'