


14-1

KANAWHA

COWL ST.

9TH ST.

N

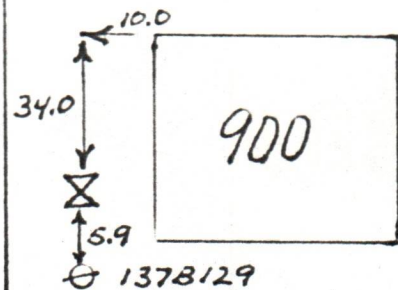

TERRACE

N3W3