


N3W3

N

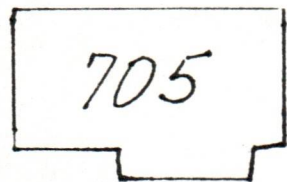

$\frac{22}{28}$ 0

14.6

6" PLASTIC

3.0

22.0

4.0

↑
TO
7TH AVE.

ALLEY

TO
KANAWHA
TERRACE
↓

10TH ST.