


10-2

N

N3W3

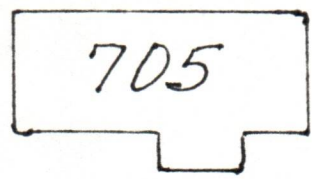

$\frac{22}{28} \emptyset$

4" GAL.

11.4

7.0



12.0

1.0

↑  
TO  
7TH AVE.

ALLEY

TO  
KAN. TER.



10TH ST.