


N3W3

18-1

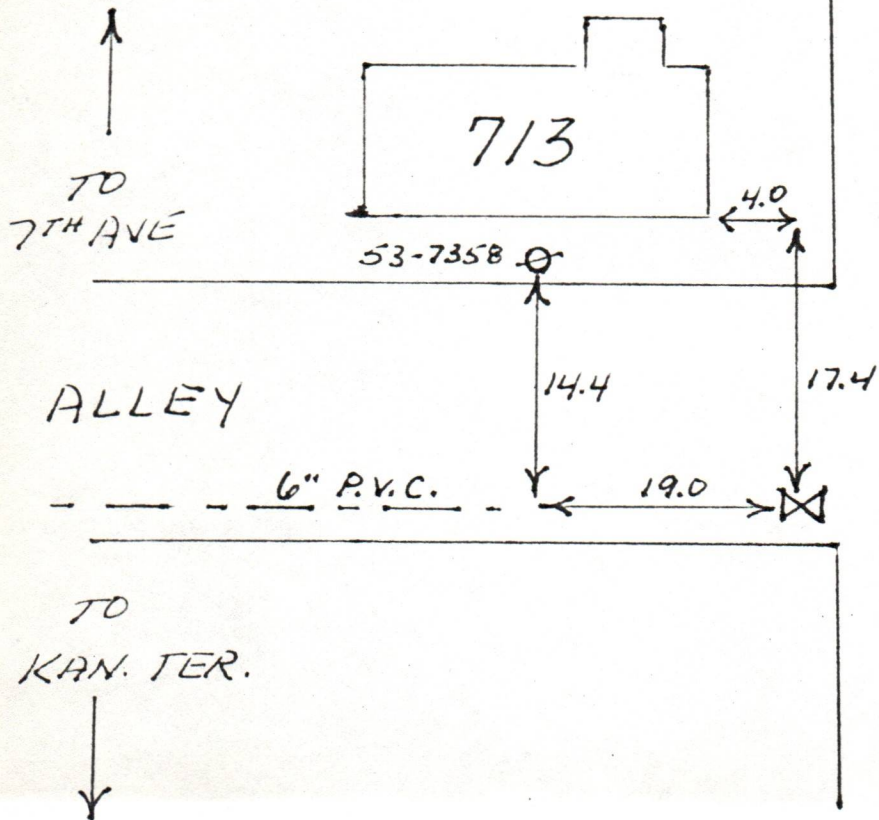

N
PARK STREET

E