

19-1

N3W3


824

825

820

6" D.I.

6" D.I.

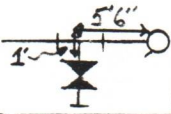

SKINNER DR.

902