

5-1


N

N3W3

10TH STREET


SIXTH

AVE.

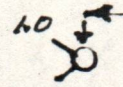

34.7

Gas stop

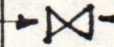

25.0

2" GAL.

31.4

