

1-1

N3W4

STREET


EIGHTH

AVENUE

E

313

4TH

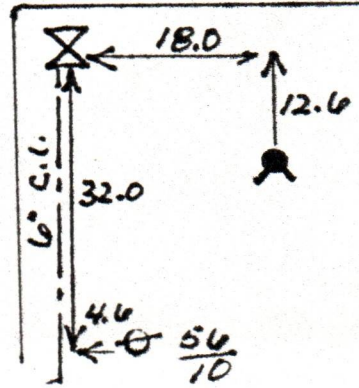

405