

N3W4

N

1-2



ST.

EIGHTH

AVENUE

2" GAL.

FOURTH

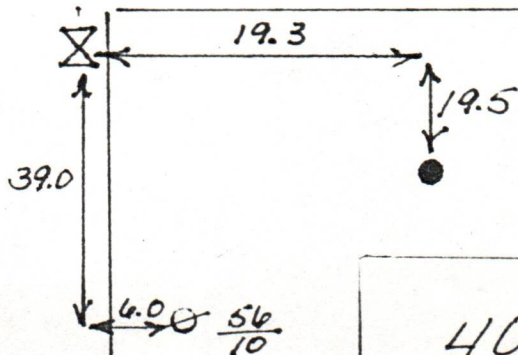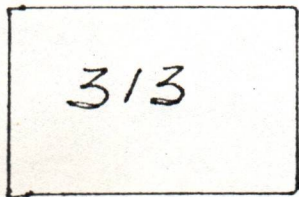

405