


Highland Drive

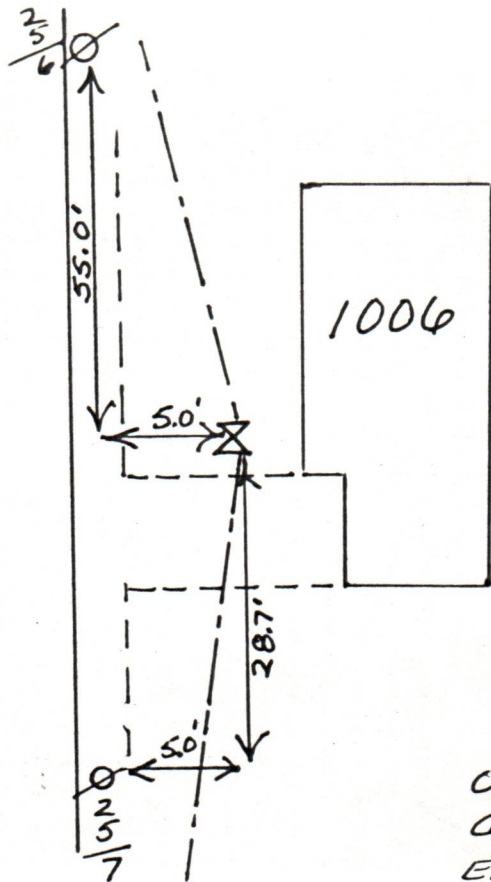

OWNER
DISPUTES
EASEMENT

14-1