

15-1

N3W4

HIGHLAND

TERRACE




NINTH

AVENUE

DEAD
END

2" C.L.

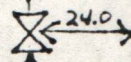

24.0

16.4

2.0

7.0

137B348

922