


N3W4

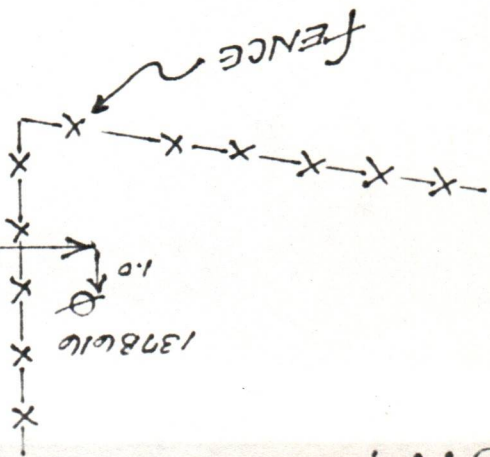

N


HELENE ST.

33.0

2 1/4" C.C.

34.0

9.6

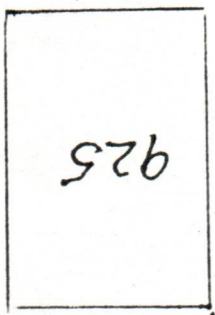

W

16-1