


10-1

N3W5

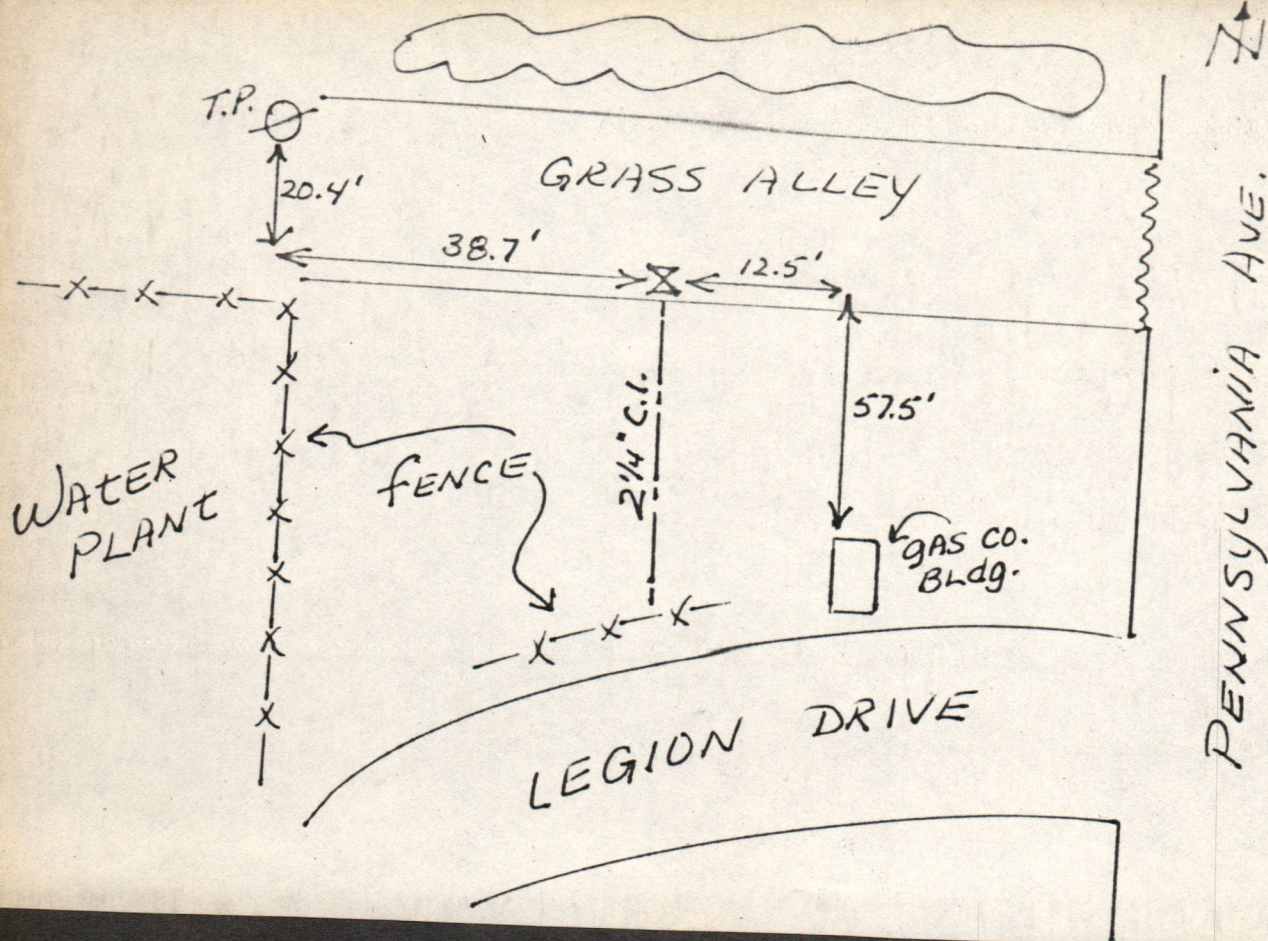

E