



N3W5

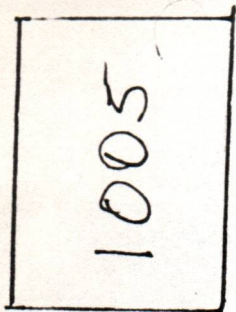

DRIVEWAY
FOR
1005

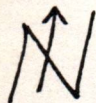

B STREET

8" C.I.

NINTH AVE

137'

11'

12" C.I.

12" C.I.

St Albans
WATER OFFICES