


N3W3

11-3

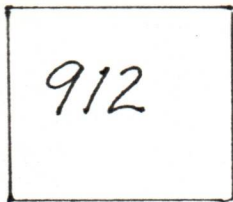

912

N

40.0

Ø NO #

S.D.

THIRD St.

34.0

NINTH

AVENUE

5.0

40.0

Ø 136 DBS

S.D.

12" C.L.