


3-1?

N3W3



"B" STREET

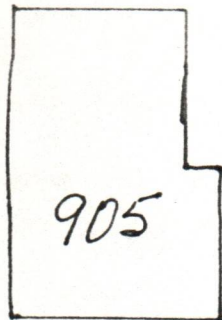

2.0

13.0

4.4
T.P.
4.4
Ø 65A

2 1/4" C.I.

GRASS ALLEY

