


N3W5

136 D 65

3-1

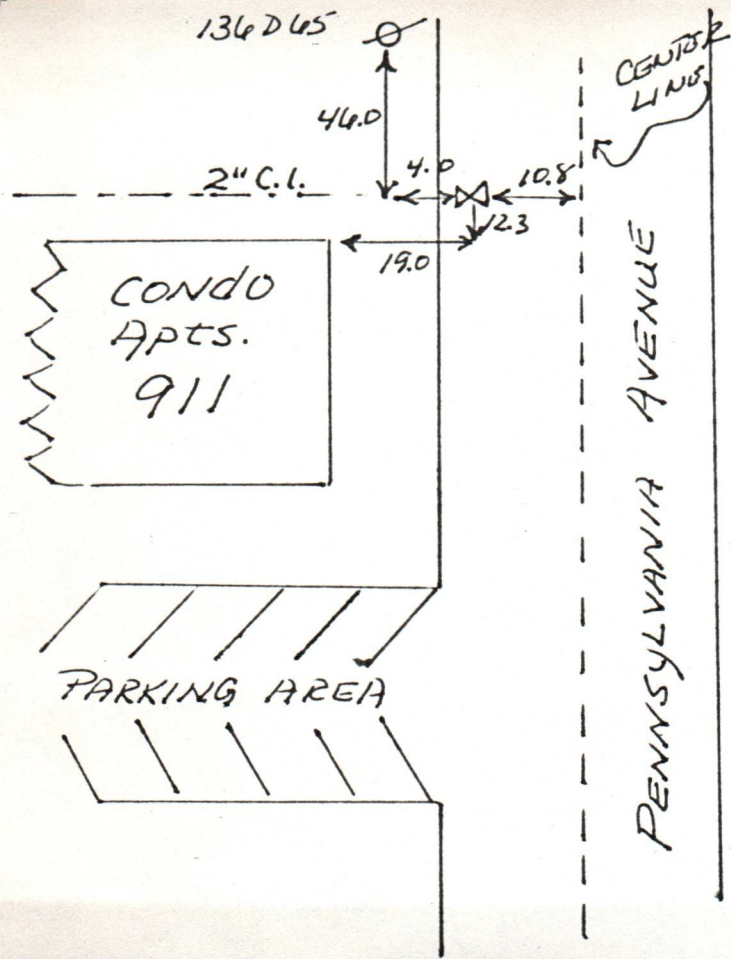

E