


N3W5

W

"B" STREET

↑

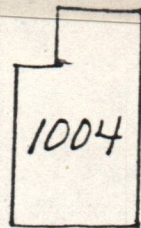

GRASS ALLEY

