
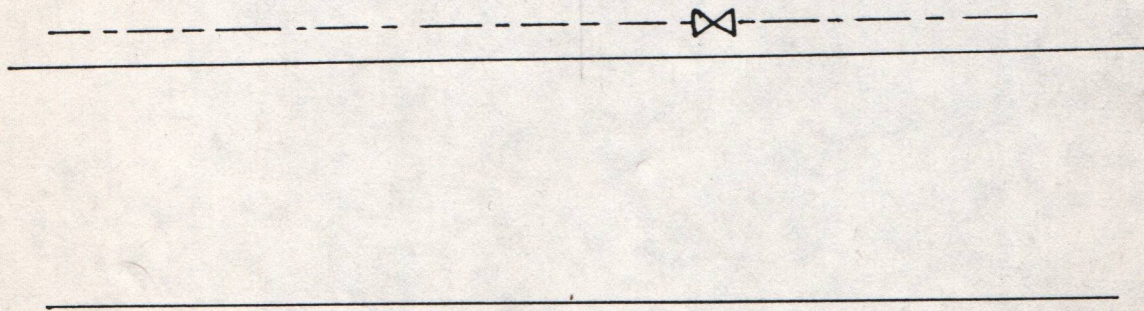


N4E1

14-1

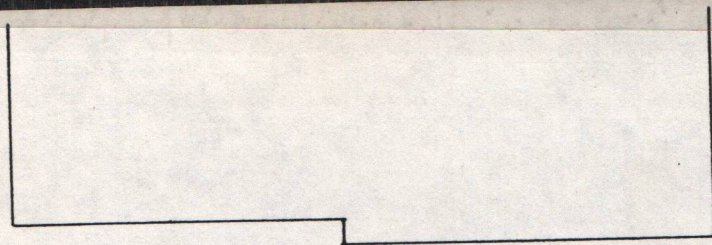

CAN'T LOCATE - 2 1/4" C.I.