


N4E1

18-1

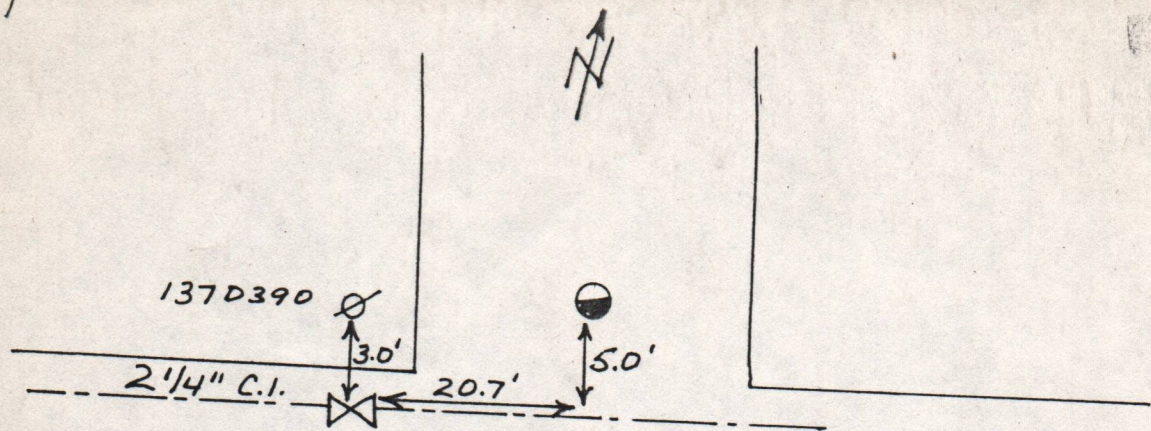

CLEVELAND

AVENUE

Hudson

