


N4E1

18-2

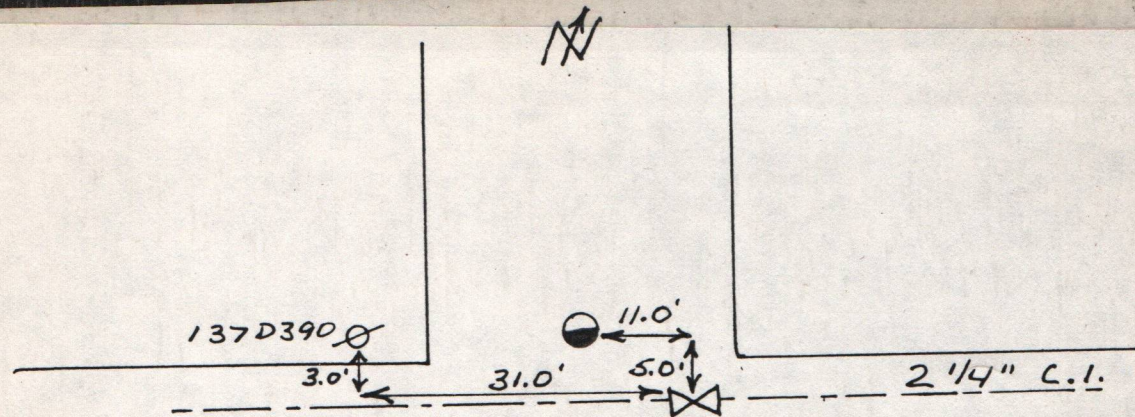

CLEVELAND AVENUE

HUDSON

