


14-1

N4E2




FIELD

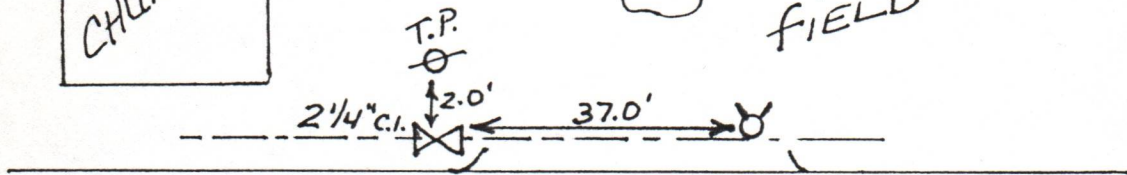

CLEVELAND

AVENUE

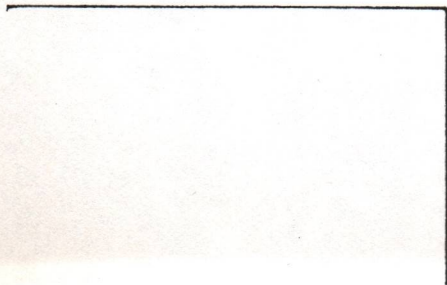

VINE St.

