


N4E2

114-2

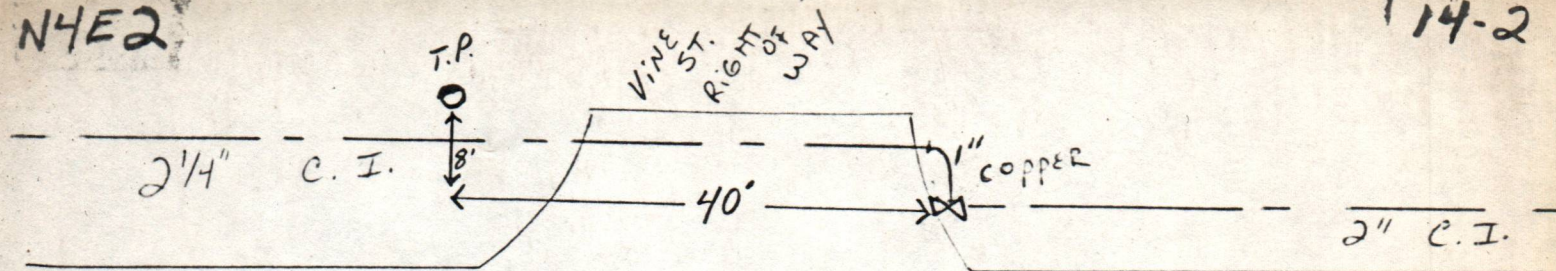

CLEVELAND

AVE

