


20-2

N4E2

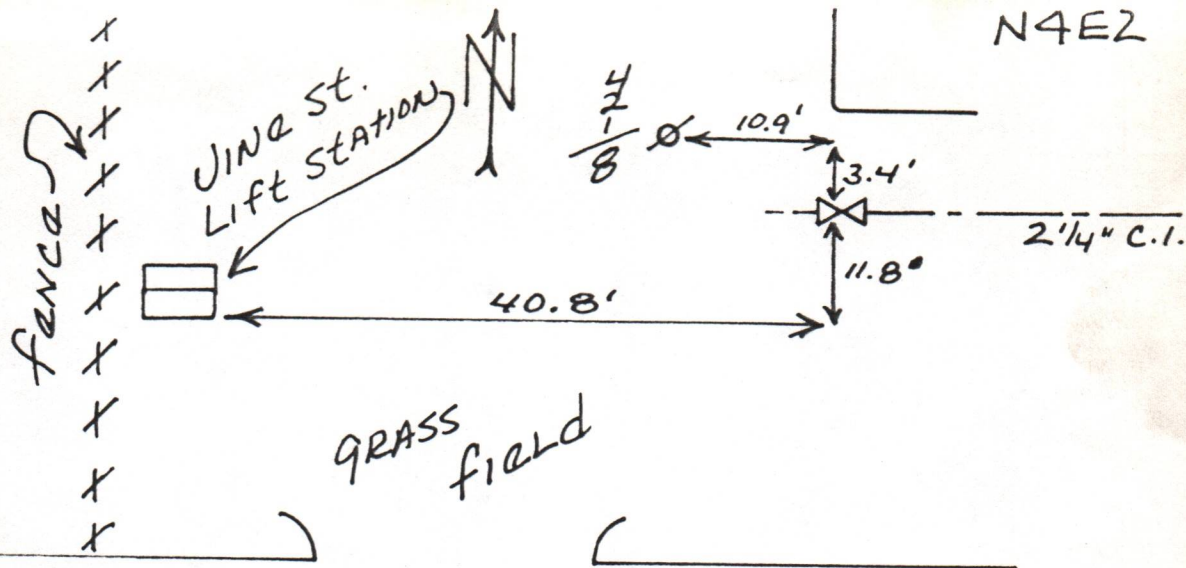

HARRISON

AVENUE

VINE ST.