


27-1

STATE ROAD MAN. DEPT.

N4E2

X X X X X X X X X X X X X X

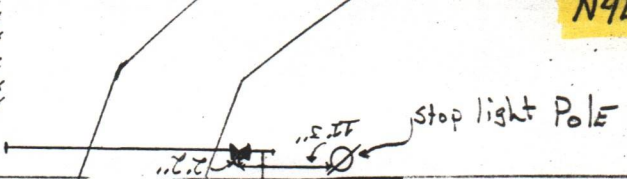

McCORKLE AVE.

WALNUT
ST.

Exxon
Station →

CLEVELAND AVE.