


1-1



2' 1/4" C.I.

N4W1

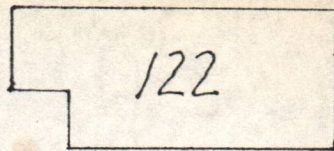

122

3.0'

12.1'

22.0'



JACKSON

35.8'

AVENUE

137A181



Cody St.