


10-2

N

N4W1

JACKSON AVENUE

CUSTER St.

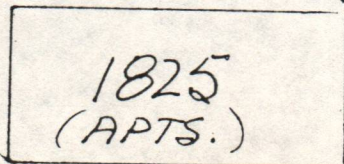

13.2'

34.7'

35.0'

5.0'

8" C.I.

